
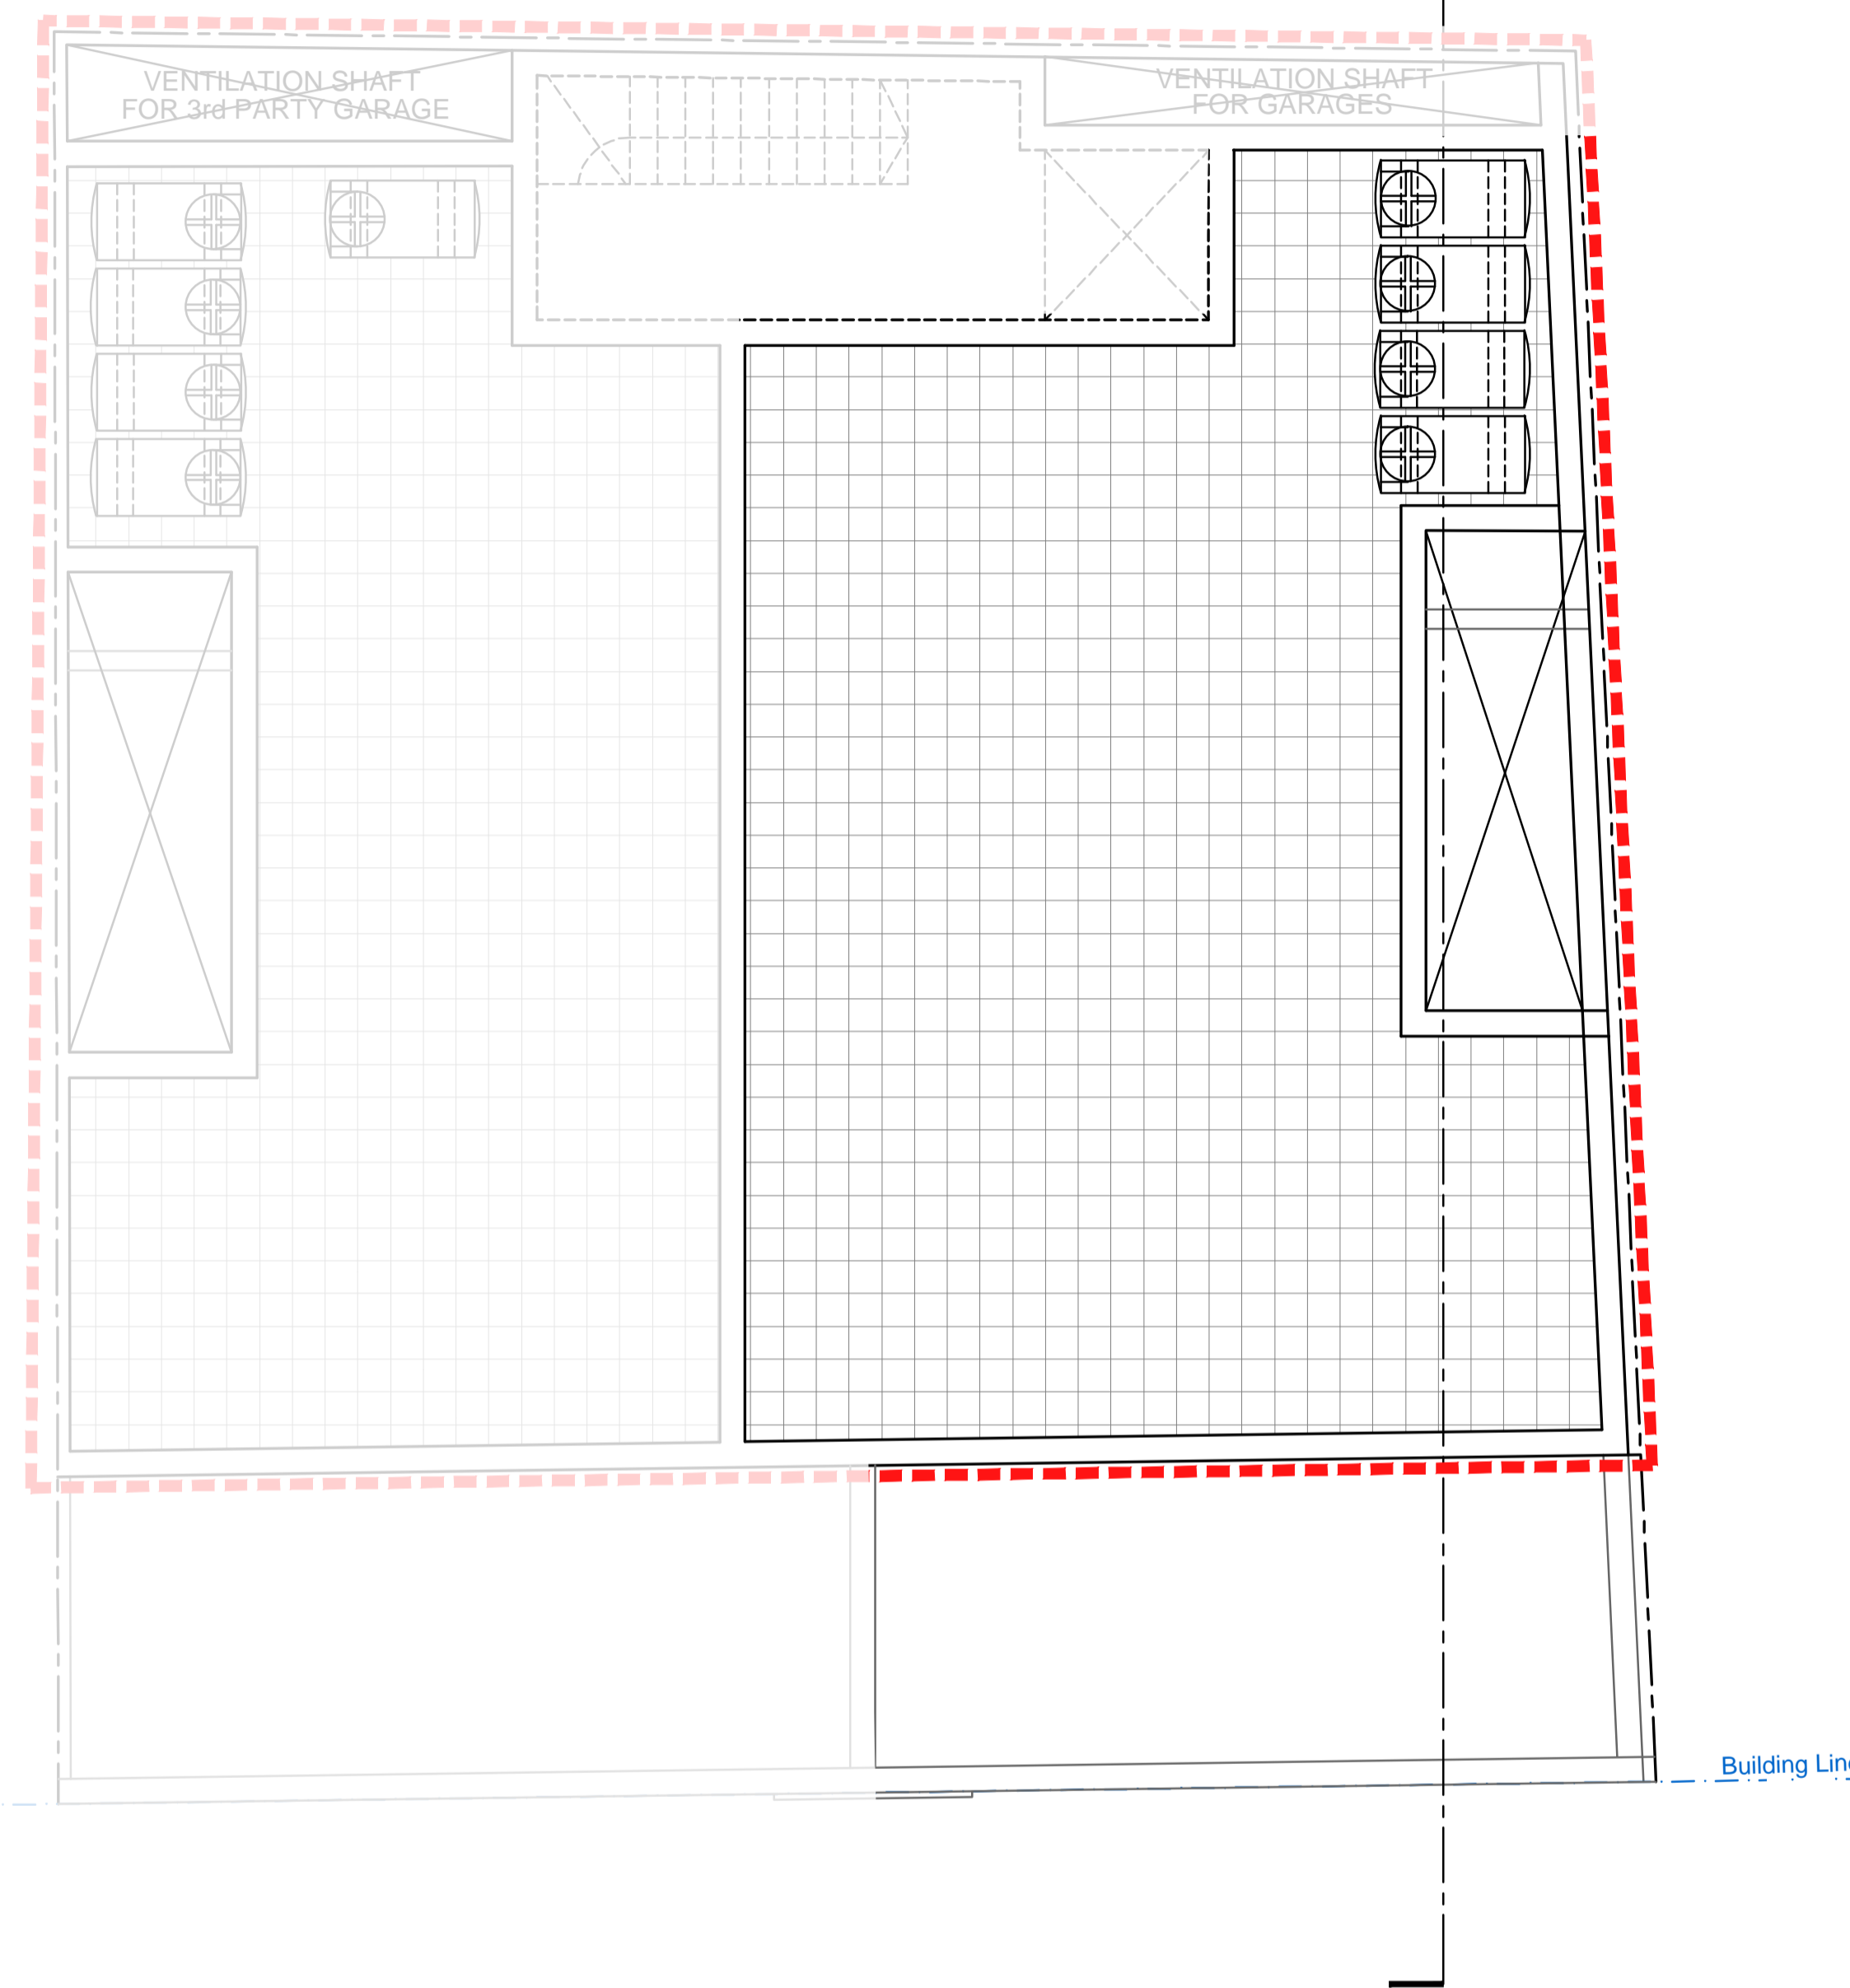


5 Proposed Set-Back Level 1:100

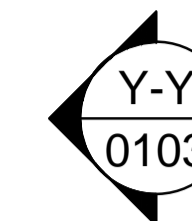

6 Proposed Roof 1:100

LEGEND

- as approved
- as built
- to demolish
- to construct

ISSUED TO PA

Rev	Date	By	Description
01	2025-08-08	RZ	Reply to PA
02	2025-09-24	RZ	Reply to PA



**PERIT KARL BORG** Architect & Civil Engineer  
 B.E. & A. (Hons.) (MEng), A. & C.E.  
 ARCHITECT & CIVIL ENGINEER

Client: **Clive Vella**

Project: **To Demolish Existing Terraced house, Excavate to required levels and Construction of Basement Garages, Ground Floor apartment, Frist to Third Floor Apartments and Penthouses at Set-Back Floor Level**

Drawing: **Proposed Plans**

Drawn by: **RZ** Checked by: **KB**

Scale: **1:100** Sheet: **A1** Date: **2025-04-29**

Job	Stage	Dwg	Rev
01653	P	0101	02